

Preliminary Plot Plan



—X—X— FENCE LINE


—P—P— OVERHEAD POWER LINE

⑤

APPROVAL



CADD DRAWING: DO NOT MAKE MANUAL REVISIONS

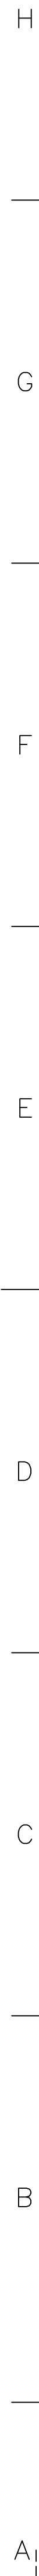SCALE 1:300	DRAWING No 18657-02-MS-02-001	RE
----------------	----------------------------------	----




—X— FENCE LINE

—T— BURRIED TELEPHONE LINE

 TransCanada <i>In business to deliver</i>			
RICHMOND NORTH SALES METER STATION			
FIA # 18657	CHAINAGE: 02	DISCIPLINE # 02	
RICHMOND SALES METER STATION PLOT PLAN			
SCALE 1:300	DRAWING No. 18657-02-MS-02-002		REV. 0A

ORIGINAL SIZES - 508 X 762mm & FINISHED SIZE - 504 X 841mm

BASE A1-19990008

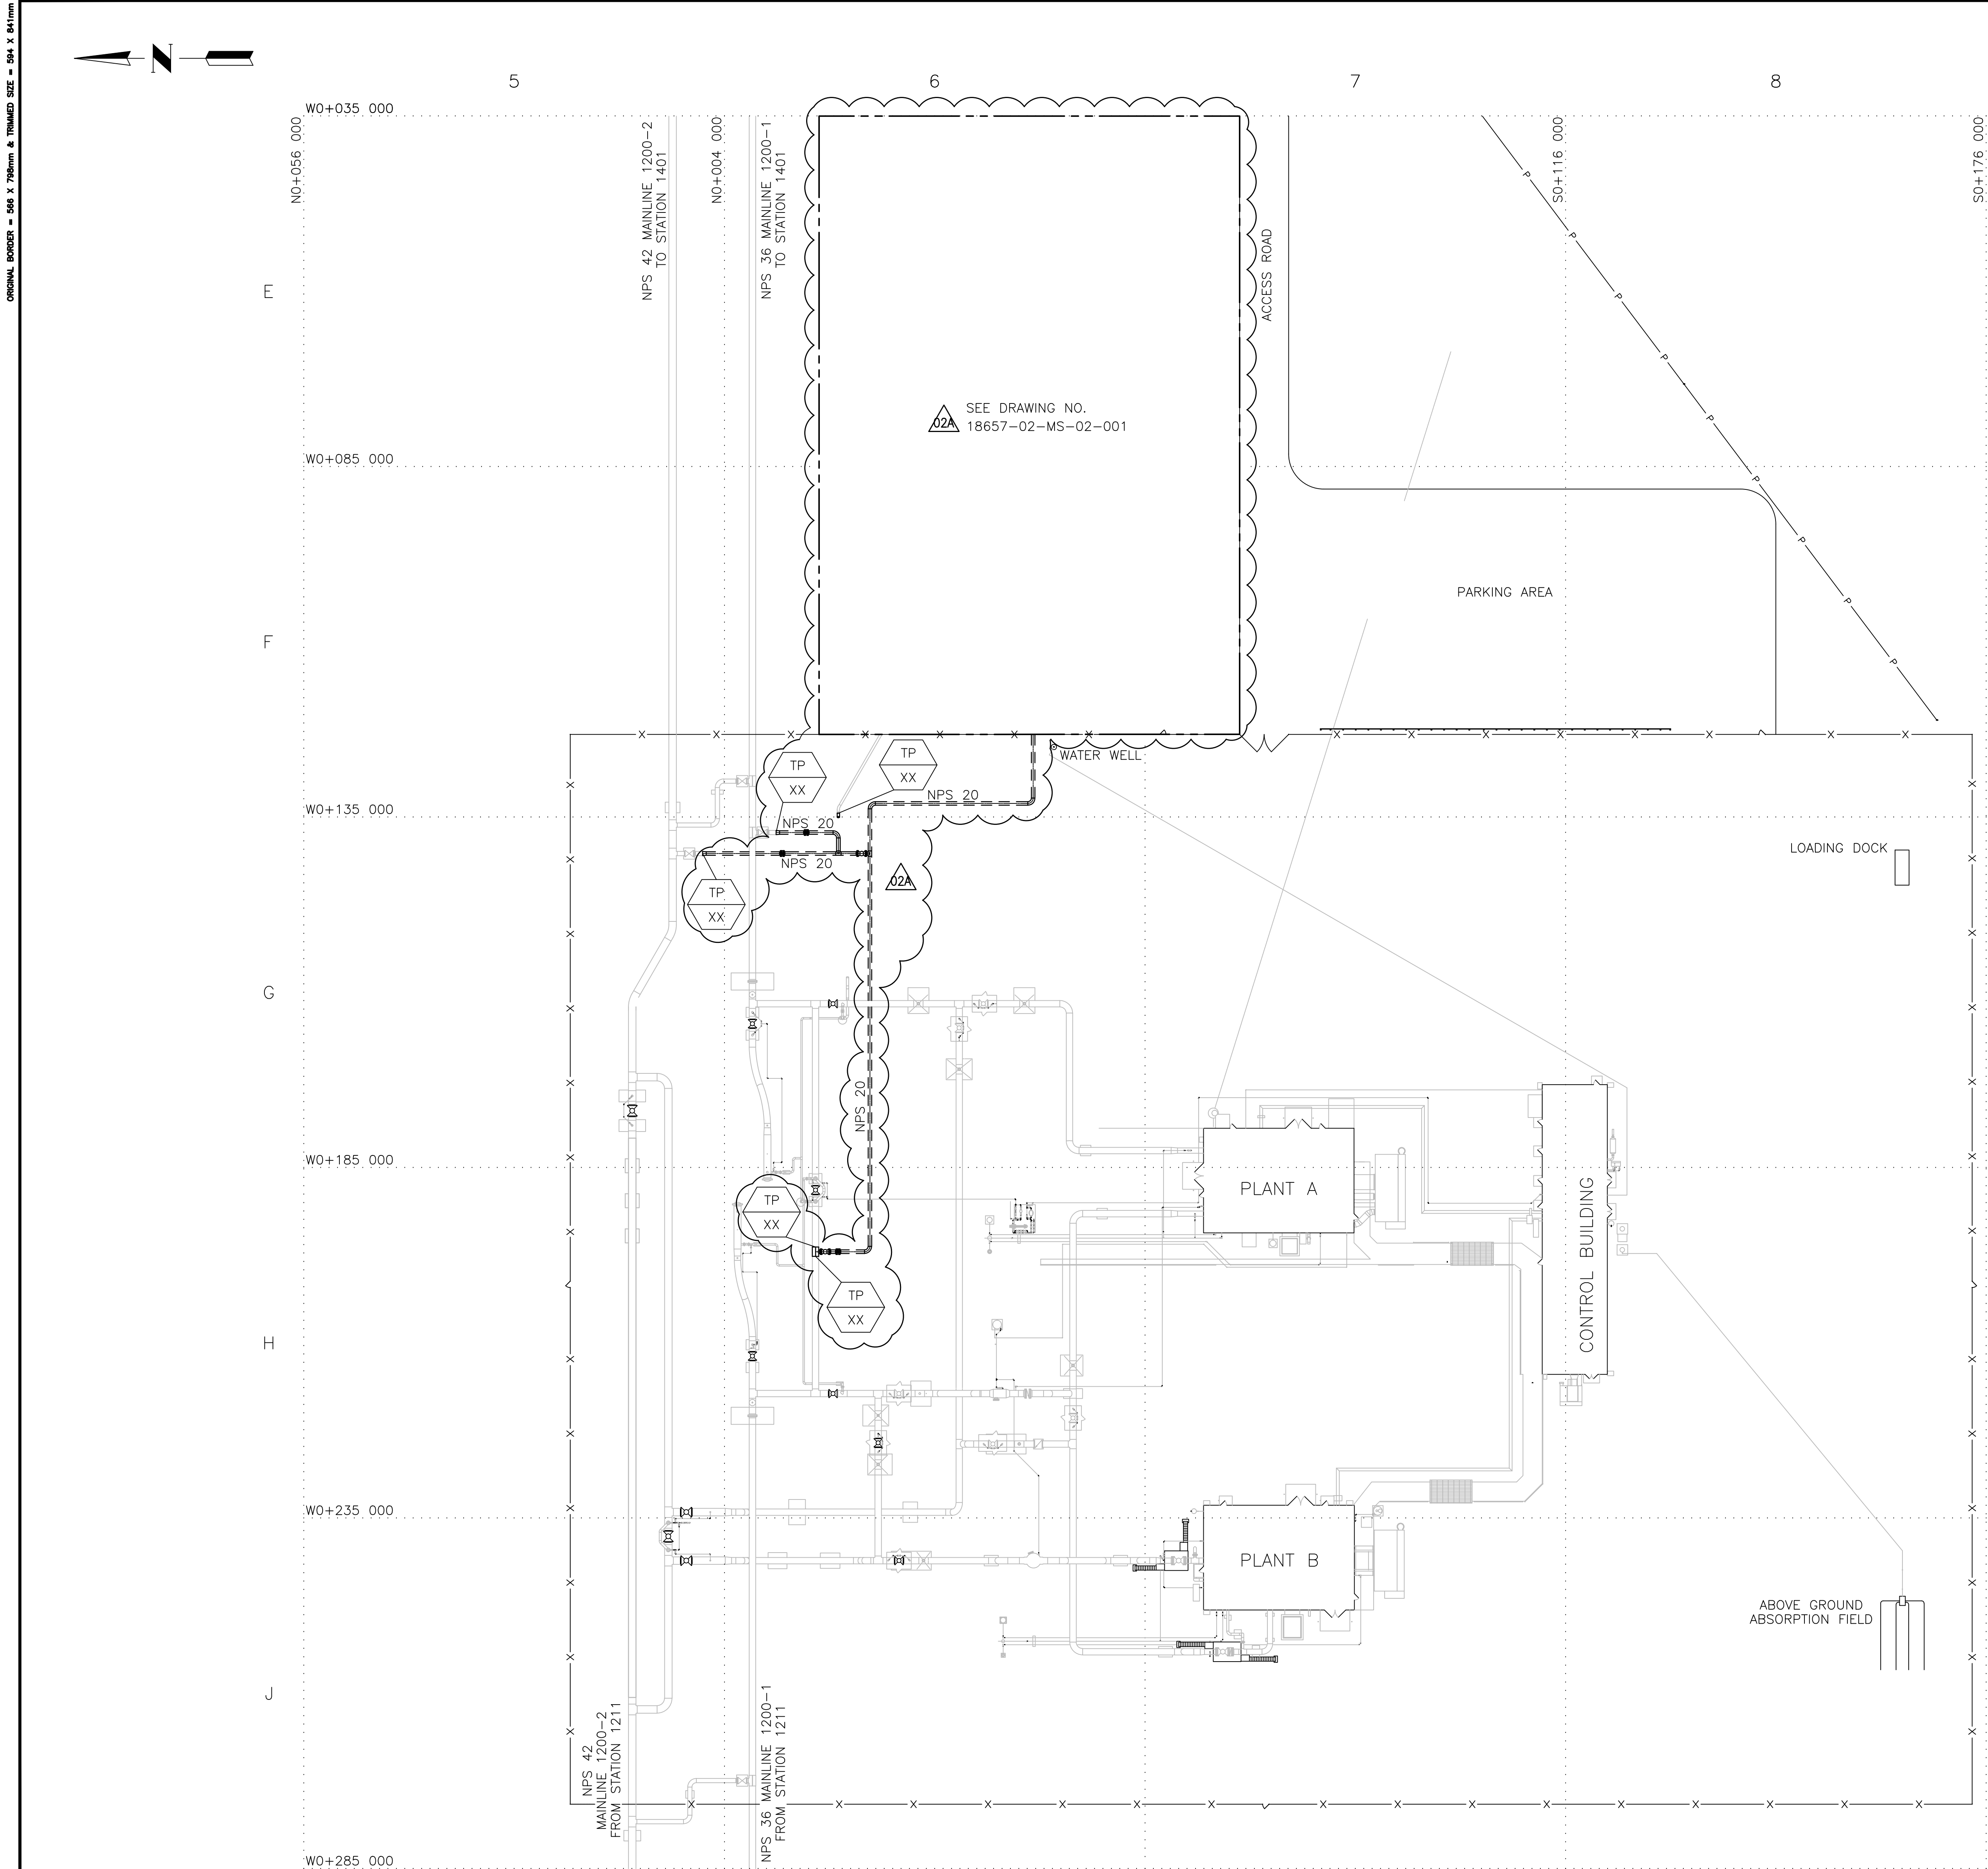

REFERENCE DRAWINGS	
NUMBER	TITLE
8845-01-ML-04-001	NPS 42 LINE NO. 1200-2 TIE-IN AT COMPRESSOR
	STATION 1217 ISOMETRIC
8845-02-ML-03-001	SADDLE SUPPORT LOCATION PLAN FOR NPS 42 LINE
	NO. 1200-2 TIE-IN AT COMPRESSOR STATION 1217

LEGEND	
	FENCE LINE
	OVERHEAD POWER LINE

02A	2017-02-15	2.226644	ISSUED FOR INFORMATION	CP	KP	KO	JV	MK		CH2M
01	2015-02-20	2.226644	ISSUED FOR CONSTRUCTION	HS						STARCO
0	1999-04-05	T00762	NOVEMBER 1998 ASBUILT	CJM	JvB	COA				CALTECH

REV	DATE	TCPL PROJECT NO	REVISION DESCRIPTION	REV BY	CHK BY	CO-ORD	DSGN ENG	SUPV ENG	PROJ E/M	COMPANY
DRAWING TITLE										
KEY PLAN										
REGIONAL MUNICIPALITY OF OTTAWA-CARLETON ONTARIO										
LOCATION: STATION No. 1217										
DRAFTER	C. MILLER	DATE	1999-01-08	CONTRACTOR FILE/DRAWING NUMBER						
CHECKER	RFB	DATE	1999-05-20	TCPL PROJECT NUMBER T00762 DWG SCALE 1:500						
COORDINATOR	C. ANTELO	DATE	1999-05-20	TCPL DRAWING NUMBER						
DESIGN ENG		DATE		A1-1217ST-01-L1-01						
PROJ MGR		DATE								
ENG SUPV		DATE								
										02A
										REV

DATE LAST SAVED: 2014-11-20 11:35 PLOT SCALE: 1=500